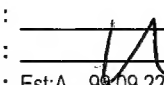
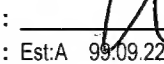


Date: Monday, 10/03/2008 3:44:35 PM
 User: Linda Lacelle

Process Sheet

Customer : CU-DAR001 Dart Helicopters Services	Drawing Name : GUSSET
Job Number : 37759	
Estimate Number : 10934	
P.O. Number :	Part Number : D2254
This Issue : 10/03/2008 S.O. No. :	Drawing Number : D2254 REV A
Prsht Rev. : NC	Project Number : N/A
First Issue : / / Type : LARGE FAB ASSY	Drawing Revision : A
Previous Run :	Material :
Written By : 	Due Date : 11/03/2008 Qty: 2 Um: Each
Checked & Approved By : 	
Comment : Est:A 99.09.22 New Issue EC	

Additional Product

Job Number:



Seq. #:	Machine Or Operation:	Description :
----------------	------------------------------	----------------------

1.0	M1010S16GA	1010/1025/A21/6aA SHEET
-----	------------	-------------------------



Comment: Qty.: 0.1084 sf(s)/Unit Total : 0.2167 sf(s)
 304/316 .063 Sheet
 Material: AISI 304/316 SS 0.063" Thick

Batch: ~~104421~~

m/ 08 03 11

2.0	SHEAR	SHEAR
-----	-------	-------



Comment: SHEAR
 Shear pattern as per Dwg D2254

m/ 08 03 11

(2)

3.0	LARGE FAB 1	LARGE FABRICATION RESOURCE 1
-----	-------------	------------------------------



Comment: LARGE FABRICATION
 Deburr

m/ 08 03 11

(2)

4.0	QC5	INSPECT WORK TO CURRENT STEP
-----	-----	------------------------------



Comment: INSPECT WORK TO CURRENT STEP

6 05/03/11 (2)

5.0	PACKAGING 1	PACKAGING RESOURCE #1
-----	-------------	-----------------------



Comment: PACKAGING RESOURCE #1
 Identify and Stock
 Location: _____

PC 8/3/11 (2)

Date: Monday, 10/03/2008 3:44:35 PM
User: Linda Lacelle

Process Sheet

Customer: CU-DAR001 Dart Helicopters Services

Drawing Name: GUSSET

Job Number: 37759

Part Number: D2254

Job Number:



Seq. #:

Machine Or Operation:

Description :

6.0

QC21

FINAL INSPECTION/W/O RELEASE



②

Comment: FINAL INSPECTION/W/O RELEASE

08/03/11

Job Completion




08.03.11

Bob Fisher
parts for Basket



PREPARED	DART AERO ACCESSORIES INC	
B. Williams	VICTORIA INTERNATIONAL AIRPORT, CANADA	
CHECKED	D2254	REV. A SHEET 1 OF 1
DATE	TITLE	SCALE
Dec. 13, 1994	GUSSET	1:1
A	94.12.13	NEW ISSUE
AI	PT 04.06.15	UPDATE DIMENSIONS

RELEASED
99.10.12 KE

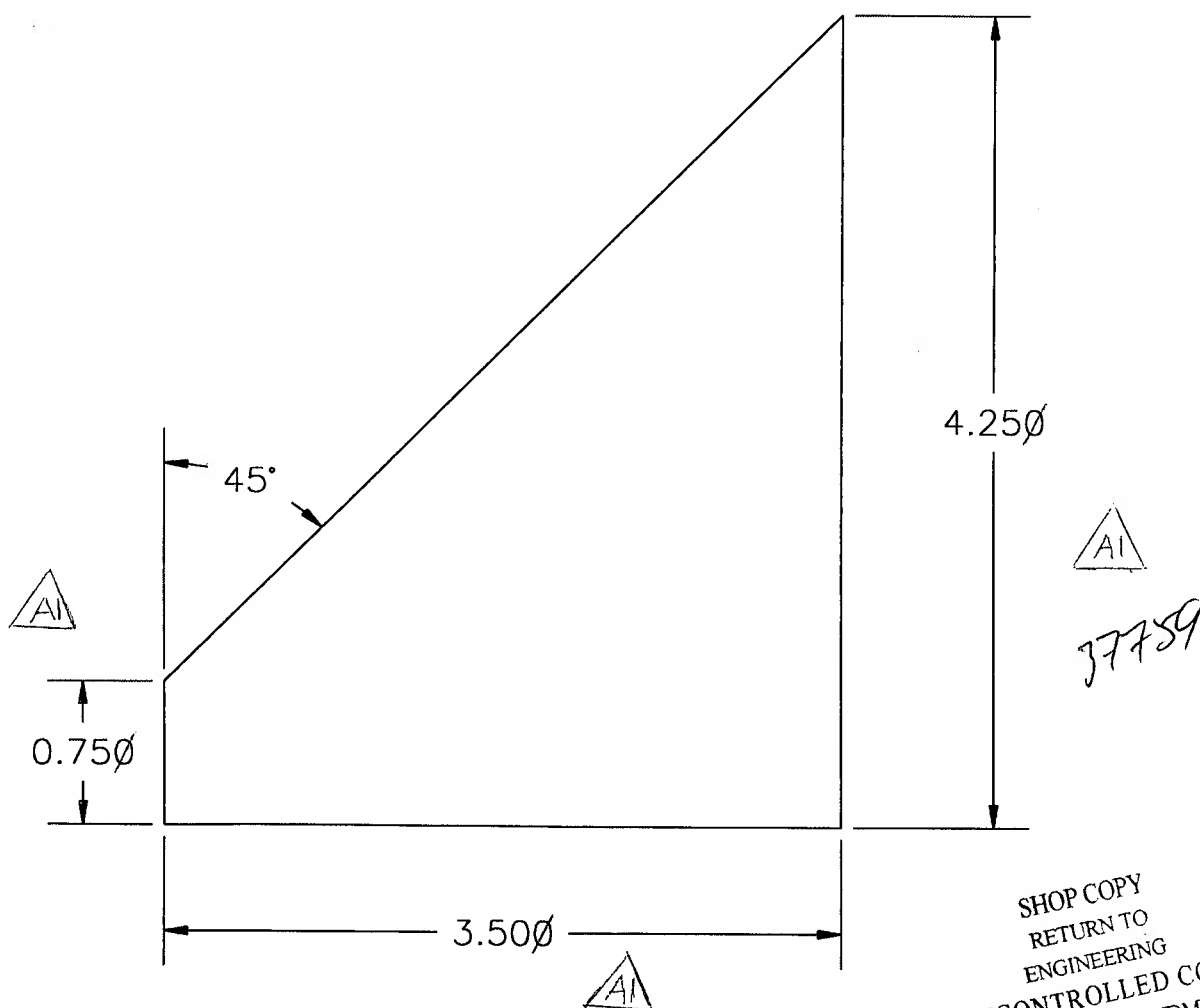

SHOP COPY
RETURN TO
ENGINEERING
UNCONTROLLED COPY
SUBJECT TO AMENDMENT
WITHOUT NOTICE
WORK ORDER

MATERIAL: 304/316 SS 0.063 THICK

1010-1025 STEEL
(16 GAUGE)

(M1010-S16GA)

FOR DSI 9406 ONLY NO. _____
~~PT~~ 06.03.06

